

Project

CONNECTICUT STATE
MEDICAL SOCIETY

127 Washington Avenue
North Haven, Connecticut

Prepared For
CANDID GROUP

Project No: 2010.11

Douglas J. Roberts – Architect

110 Washington Avenue
Fourth Floor
North Haven, CT 06473
Tel: 203.234.6368
Email: droberts-architect@att.net

Key Plan

Do not scale dimensions from drawings.
Site verify all dimensions prior to construction.
Report all discrepancies to Architect immediately.
This drawing is to be read in conjunction with all relevant
documents and drawings.


Rev.	Description	Date
1	GENERAL REVISION - A -	April 2, 2012
2	GENERAL REVISION - B -	May 17, 2013
3	GENERAL REVISION - C -	Oct 27, 2013

Drawn by: PFG
Drawn Date: MAY 21 2015
Reviewed by: DJR
Project No: 2010.11
Scale: 1/8" = 1'-0"

Sheet Title:
THIRD FLOOR PLAN -
EAST

Original drawing is D. Do not scale contents of this drawing.
Sheet Number: Revision:

A-103 E

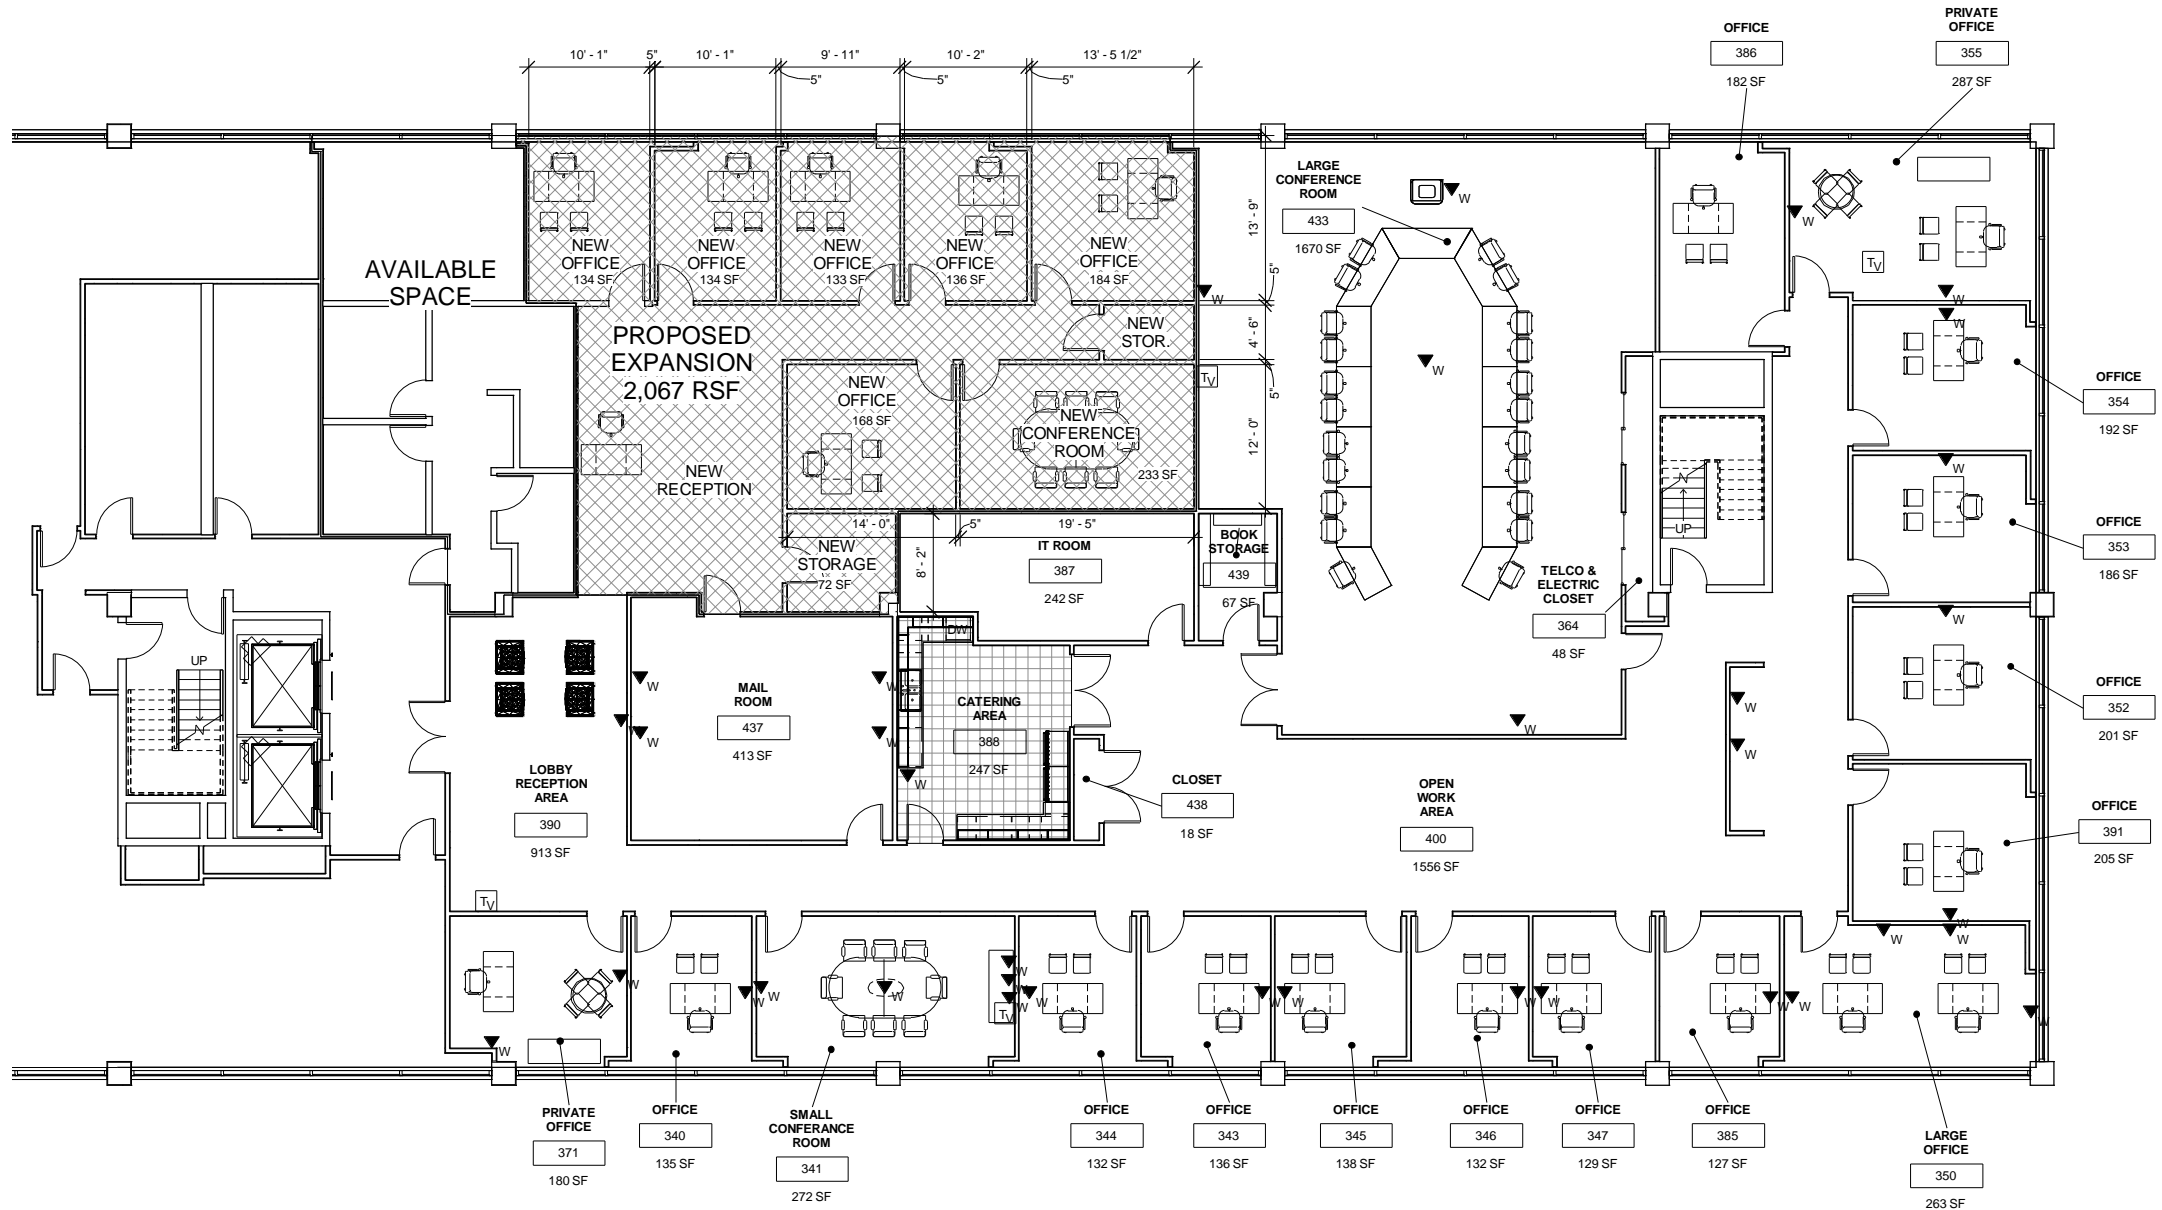

① Third Floor Level - EAST
1/8" = 1'-0"

PROPOSED OFFICE FOR
CONNECTICUT STATE MEDICAL SOCIETY

LEASE EXHIBIT -A-

127 Washington Ave.



Building Information

This 5 story building is made up of two parts; the East Building and the West Building. The East Building was built in 1976, and then in 1986 the building was expanded by adding the West Building. The building was most recently renovated in 2018 committed to Green Initiative with cogeneration and a 2019 Solar Project.

Building Size

- Building Area: 140,000 Sq. Ft
- Floor Size: 27,000 Sq. Ft

Location



Building Services

- On-Site Management
- On-Site Maintenance

Building Amenities

- Elevator
- 24/7 Building Access
- Video Surveillance
- Free Parking
- Utilities Paid
- Receptionist
- Furniture